


THIS DRAWING IS THE EXCLUSIVE PROPERTY OF CONCEPT COMPRESSION CORP. AND CANNOT BE REPRODUCED WITHOUT THE PERMISSION OF CONCEPT COMPRESSION CORP.

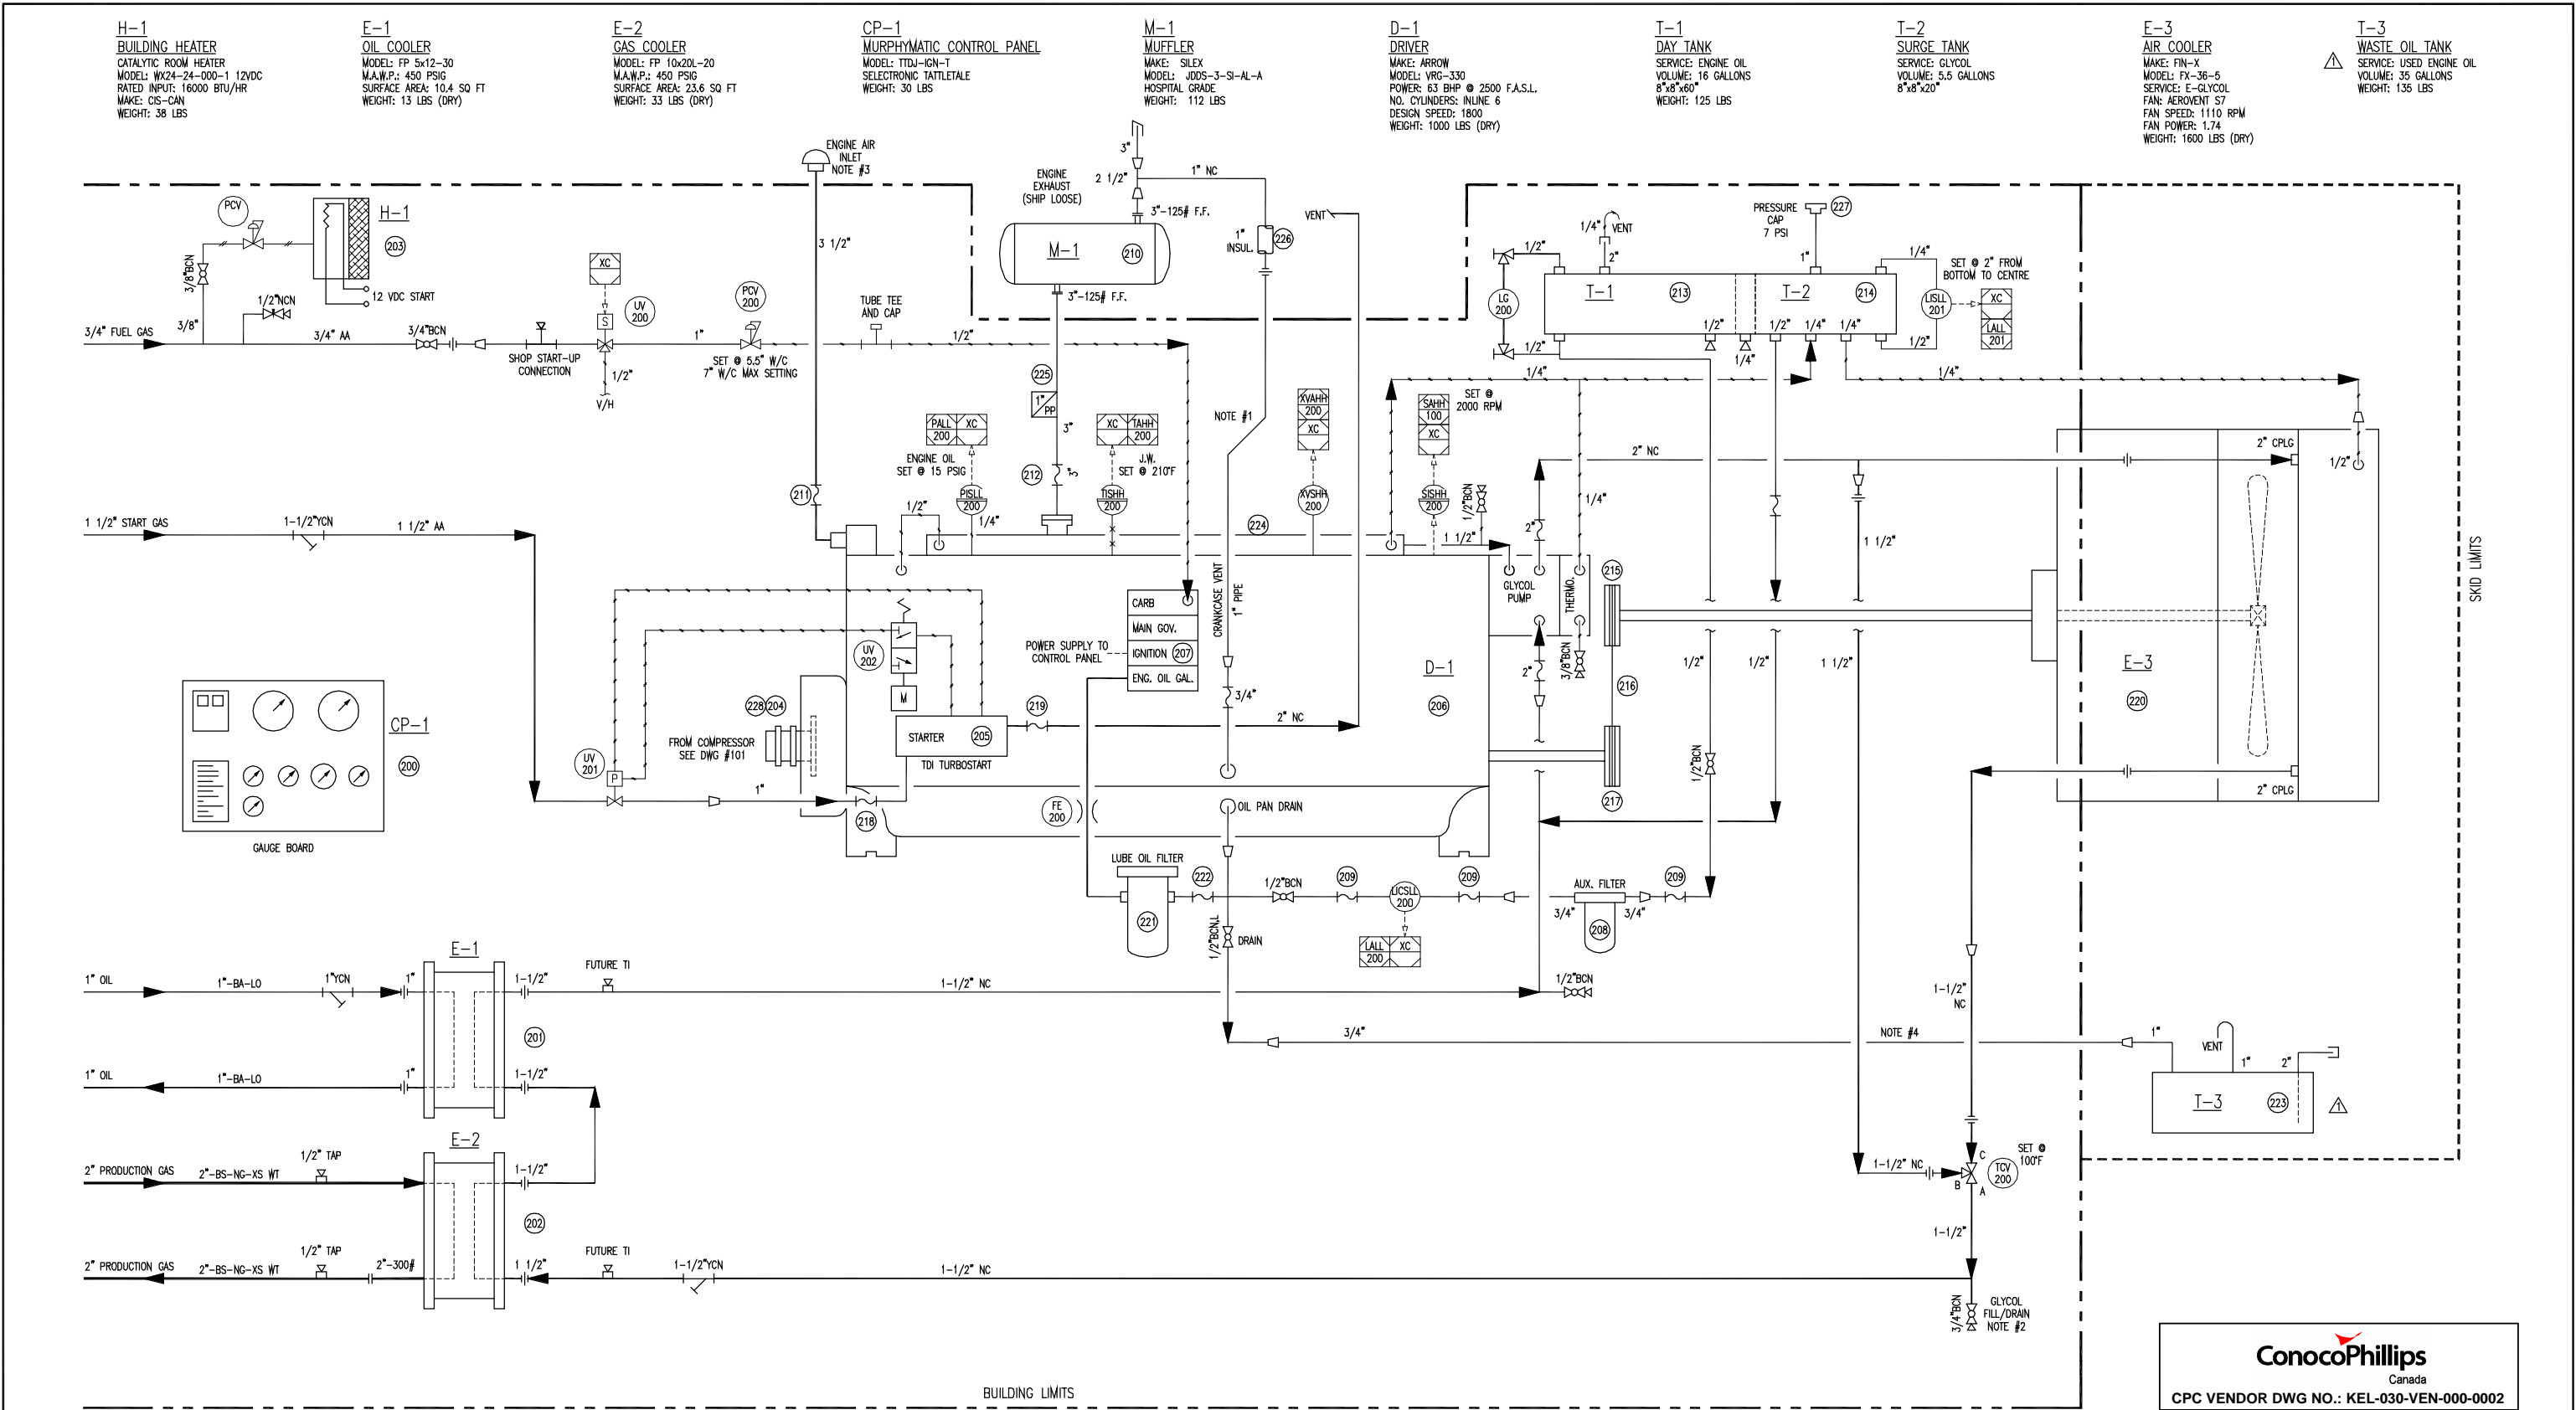

NPT/SW PIPE WT CHART		PIPE SPECIFICATION					
		NC	AA	BA	CA	AS	BS
SIZE	1/2"	XH	XH	XH	160	XXH	XXH
	3/4"	XH	XH	XH	160	160	XXH
	1"	XH	XH	XH	160	160	XXH
	1 1/4"	XH	XH	XH	160	160	XXH
	1 1/2"	XH	XH	XH	160	160	XXH

GENERAL NOTES

NOTES

1. SLOPE, DO NOT TRAP
2. LOWEST POINT ON SYSTEM
3. RAIN CAP SUPPLIED WITH ENGINE
4. SLOPE TOWARD T-3

STAMPS			
2	AS BUILT	JUNE 12/03	E.P.
1	ADDED T-3	MAY 14/03	E.P.
0	ISSUED FOR CONSTRUCTION	APR 24/03	E.P.
REV.	DESCRIPTION	DATE	BY

AS BUILT

P&ID			
CC60H UNIT			
E&D JOB# 13364-SK			
DRN. BY	E. PETERS	DATE	APR 17/03
CHK. BY		DATE	
APP. BY		DATE	
REL. NO.	100153	P/L NO.	
FOR	BURLINGTON RESOURCES		
	NOEL		
	a-91-A/93-P-7		
CHK. NO.	100153-102	REV. NO.	2